
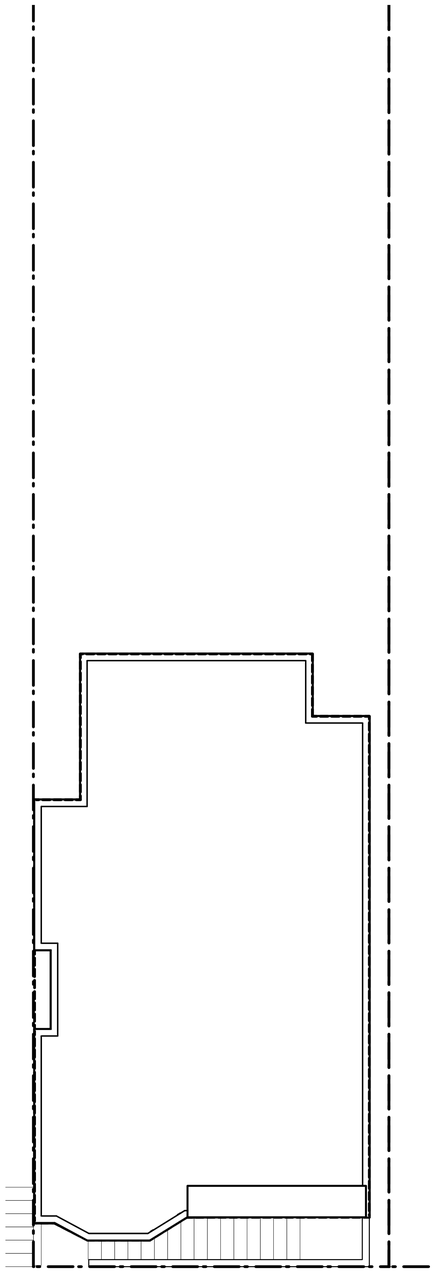


DN
6.92%


ROOF PLAN
3/16" = 1'-0"

4

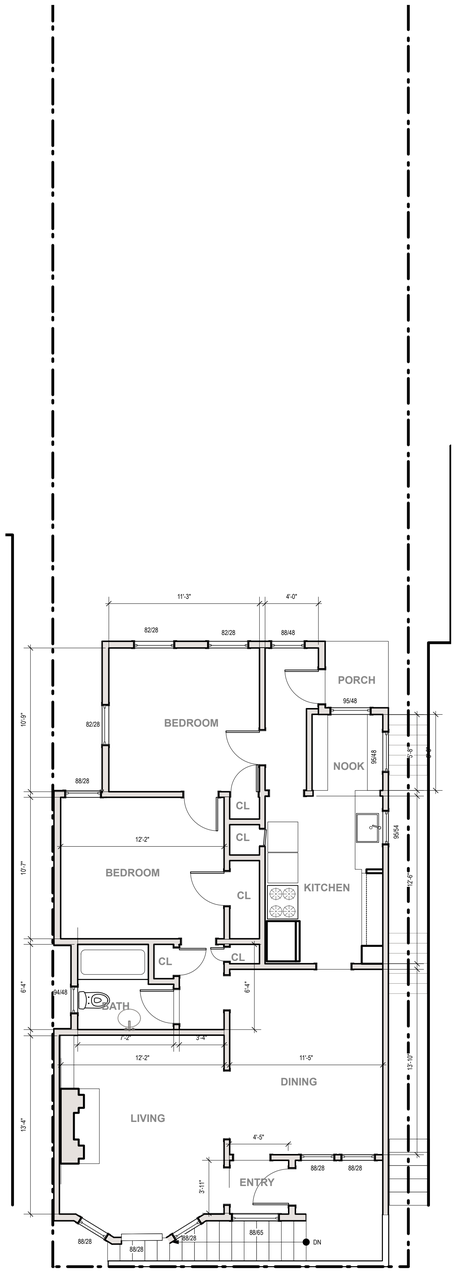

FIRST FLOOR PLAN
3/16" = 1'-0"


3

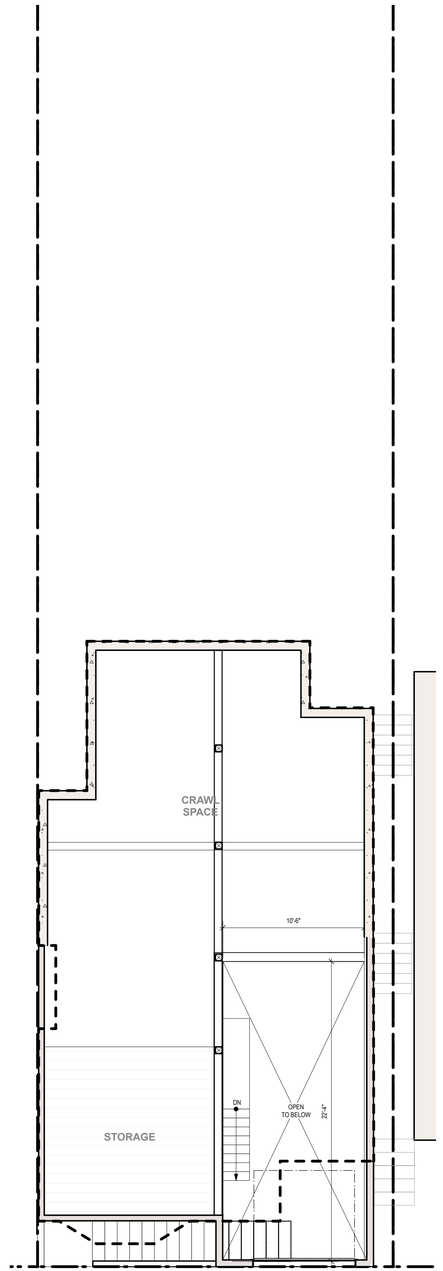

DN
6.92%

BASEMENT - UPPER LEVEL
3/16" = 1'-0"

2

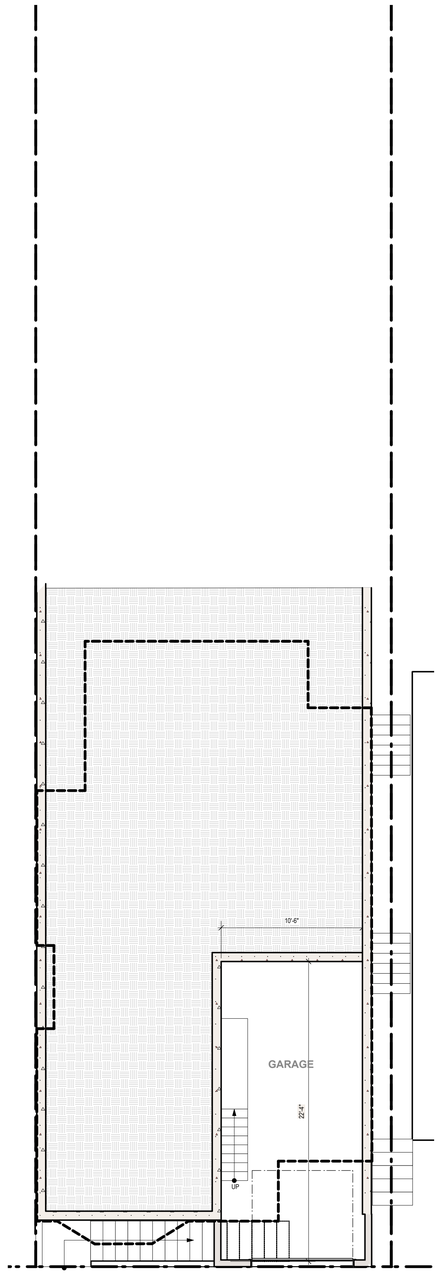

DN
8.93%

N

BASEMENT -LOWER LEVEL
3/16" = 1'-0"

1

K a+d
KNOCK architecture + design
www.knock-ad.com
ryan@knock-ad.com
415-215-2647

RESIDENCE/ADU ADDITION

4357 26TH ST, SAN FRANCISCO CA

permit #:


AS BUILT PLANS

All drawings and written material appearing herein constitute original and unpublished work of the Architect and may not be duplicated, used, or disclosed without the written consent of the Architect.

A0

SCALE:

PLOT DATE:

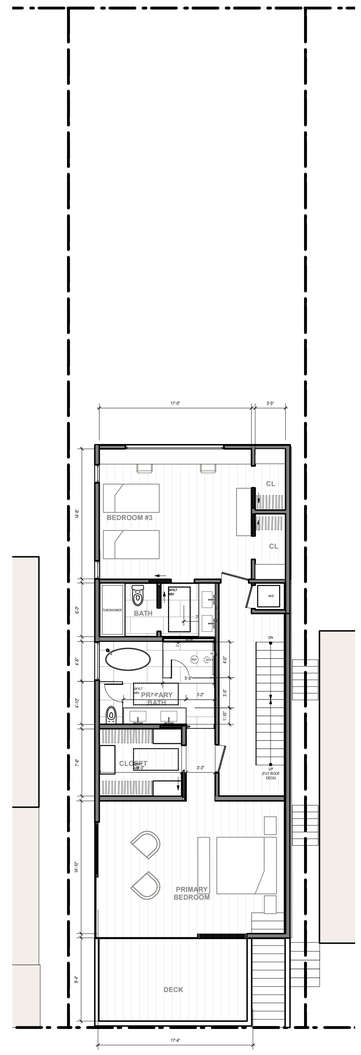


1200 SQUARE FEET

N

2ND FLOOR PLAN

1/8" = 1'-0"

2

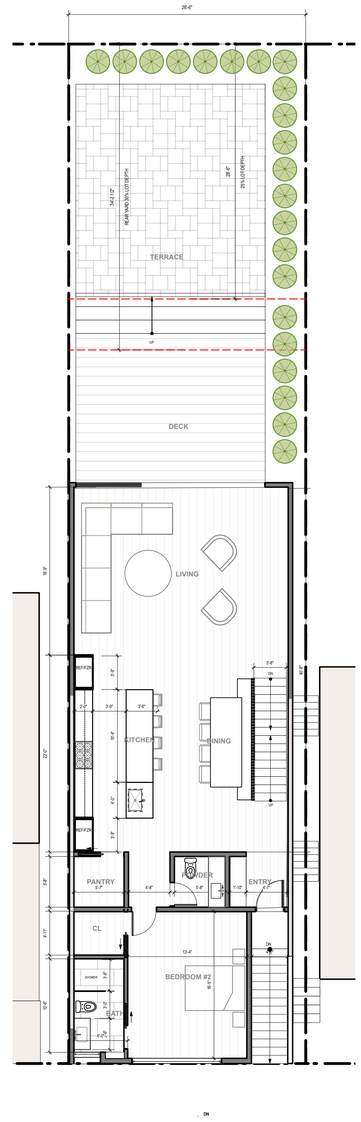


1500 SQUARE FEET

N

1ST FLOOR PLAN

1/8" = 1'-0"

1

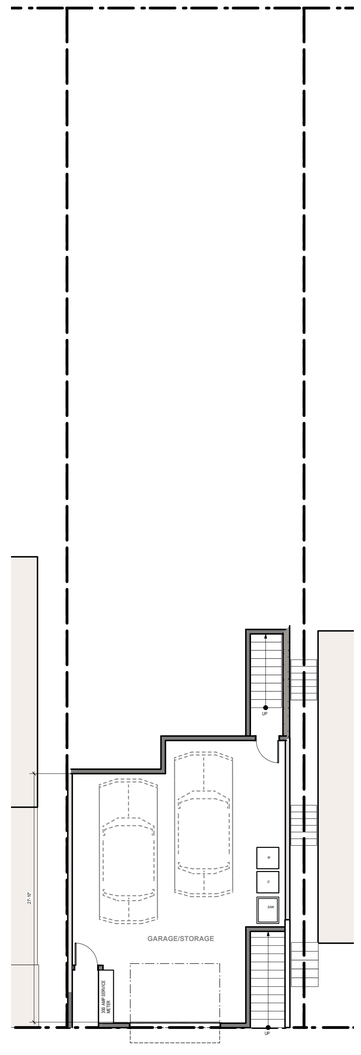

300 SQ FT PARKING + 300 SQUARE FEET GARAGE AND STORAGE

N

BASEMENT PLAN

1/8" = 1'-0"

0

PRELIMINARY
NOT FOR
CONSTRUTION

KNOCK architecture + design

www.knock-ad.com
ryan@knock-ad.com
415-215-2647

RESIDENCE/ADU ADDITION

4357 26TH ST, SAN FRANCISCO CA

permit #:


CONCEPT PLAN SFH

All drawings and written material appearing herein constitute original and unpublished work of the Architect and may not be duplicated, used, or disclosed without the written consent of the Architect.

A1

SCALE:

PLOT DATE:

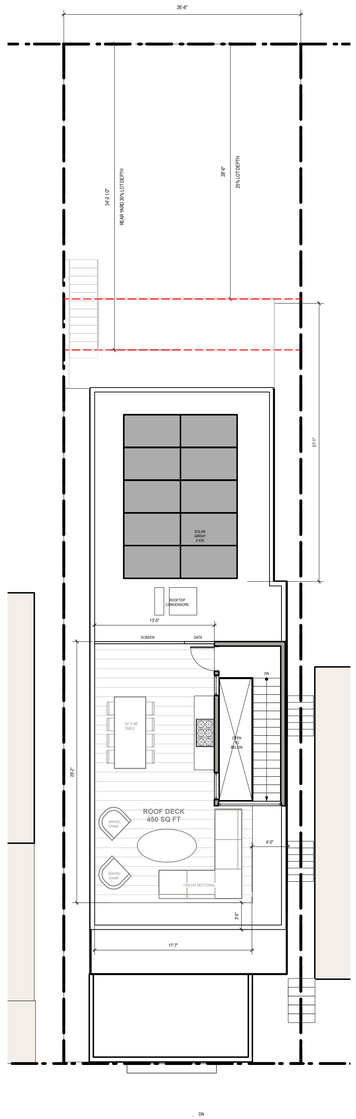


437 SQ FT ROOF DECK

N

ROOF DECK PLAN 4

1/8" = 1'-0"

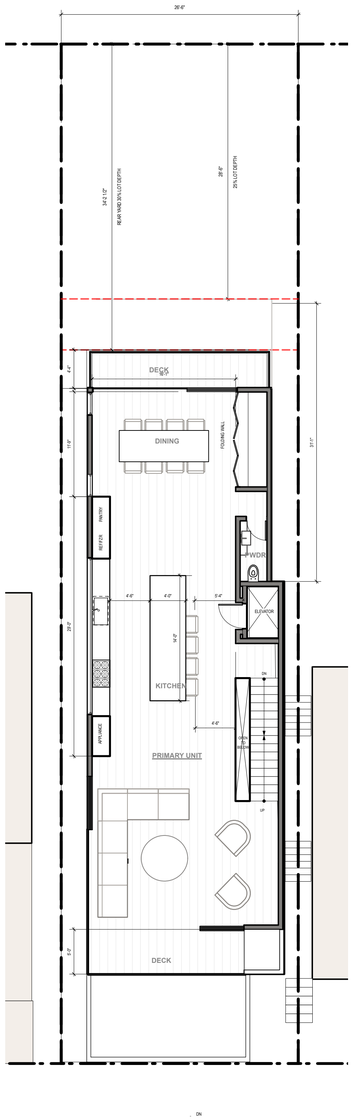


1250 SQUARE FEET

N

3RD FLOOR PLAN 3

1/8" = 1'-0"

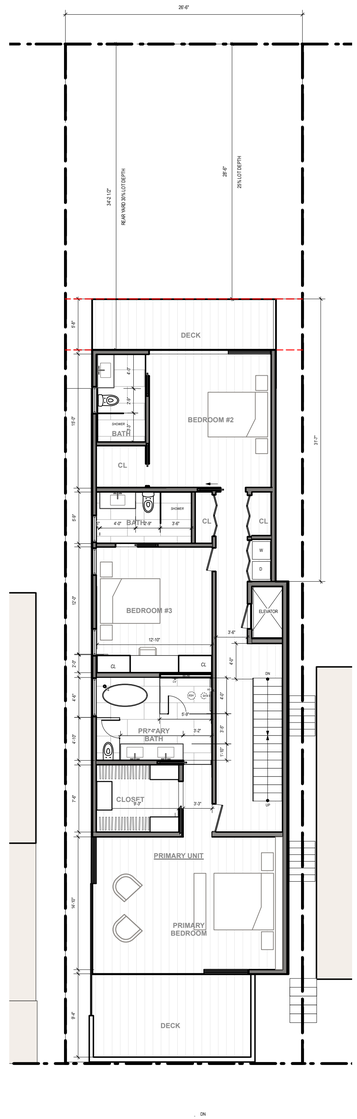


1500 SQUARE FEET

N

2ND FLOOR PLAN 2

1/8" = 1'-0"

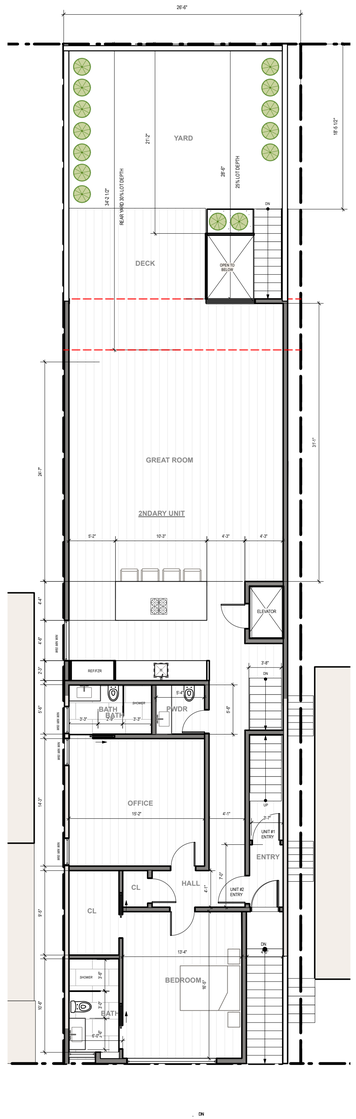


1965 SQUARE FEET 2ND UNIT, 45 SQ FT MAIN UNIT

N

1ST FLOOR PLAN 1

1/8" = 1'-0"

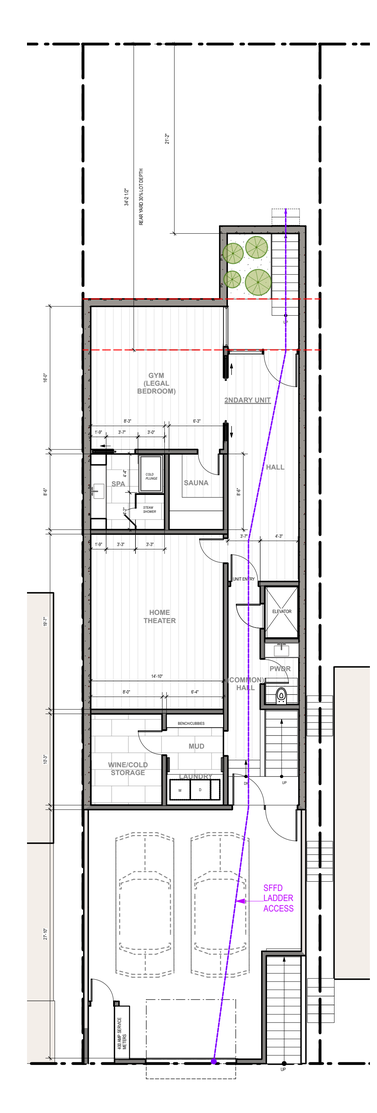

985 SQUARE FEET 2ND UNIT

N

BASEMENT PLAN 0

1/8" = 1'-0"

09.03.26	CONCEPT PLANS

PRELIMINARY NOT FOR CONSTRUTION

K a+d
KNOCK architecture + design
www.knock-ad.com
ryan@knock-ad.com
415-215-2647

RESIDENCE/ADU ADDITION

4357 26TH ST, SAN FRANCISCO CA

permit #:

TWO UNIT CONCEPT

All drawings and written material appearing herein constitute original and unpublished work of the Architect and may not be duplicated, used, or disclosed without the written consent of the Architect.

A2

SCALE:

PLOT DATE: